

**S-210  
SCREW COMPRESSOR**

Manufacturer: MYCOM  
Model: FMG 160L-M  
Max. of 80psi Suction  
Max. of 300psi Discharge  
Adjustable VI

**F-810A/B  
OIL FILTERS**


Manufacturer: DONALDSON  
Model: HMK25  
MSP: 350psig @ 250°F  
Part: P169984  
Filter: P165569

**F-840  
CONICAL STRAINER**

Manufacturer: ALBERTA STRAINER  
Model: 3"-600#  
Type: STAINLESS STEEL  
40 MESH  
150% OPEN AREA

**MATERIAL LIST**


ITEM	DESCRIPTION	MAKE	MODEL
TCV-2101	THERMOSTATIC CONTROL VALVE	AMOT	1 1/2BHC118001
DPSLL-2101	DIFFERENTIAL PRESSURE SWITCH, SET @ 10psi FALLING	CCS	604DJ2
DPISSH-2101	DIFFERENTIAL PRESSURE INDICATOR	MIDWEST	120AA-00-00M
PSLL-2102	PRESSURE SWITCH LOW, SET @ 0psi	SOR	56AG-EF316-M4-C1A-NC
PSHH-2101	PRESSURE SWITCH HIGH, SET @ 285psi Inc.	CCS	6900GZE18
PI-2103	PRESSURE INDICATOR 1/2" BTM x 2 1/2"FACE, 0-400psi/0-2800KPa	WIKA	SSLF
PI-2104	PRESSURE INDICATOR 1/2" LBM x 4"FACE, 0-400psi/0-2800KPa	WIKA	SSLF
TI-2101	TEMPERATURE INDICATOR, 3" FACE, -40 TO 160°F	TREND	
TE-2101	TEMPERATURE ELEMENT COMES WITH 4" PYROLEAD	ALTRONIC	151000157
TE-2102	TEMPERATURE ELEMENT COMES WITH 2" PYROLEAD	ALTRONIC	151000156
VSHH-2101	VIBRATION SWITCH HIGH	MURPHY	VS-2

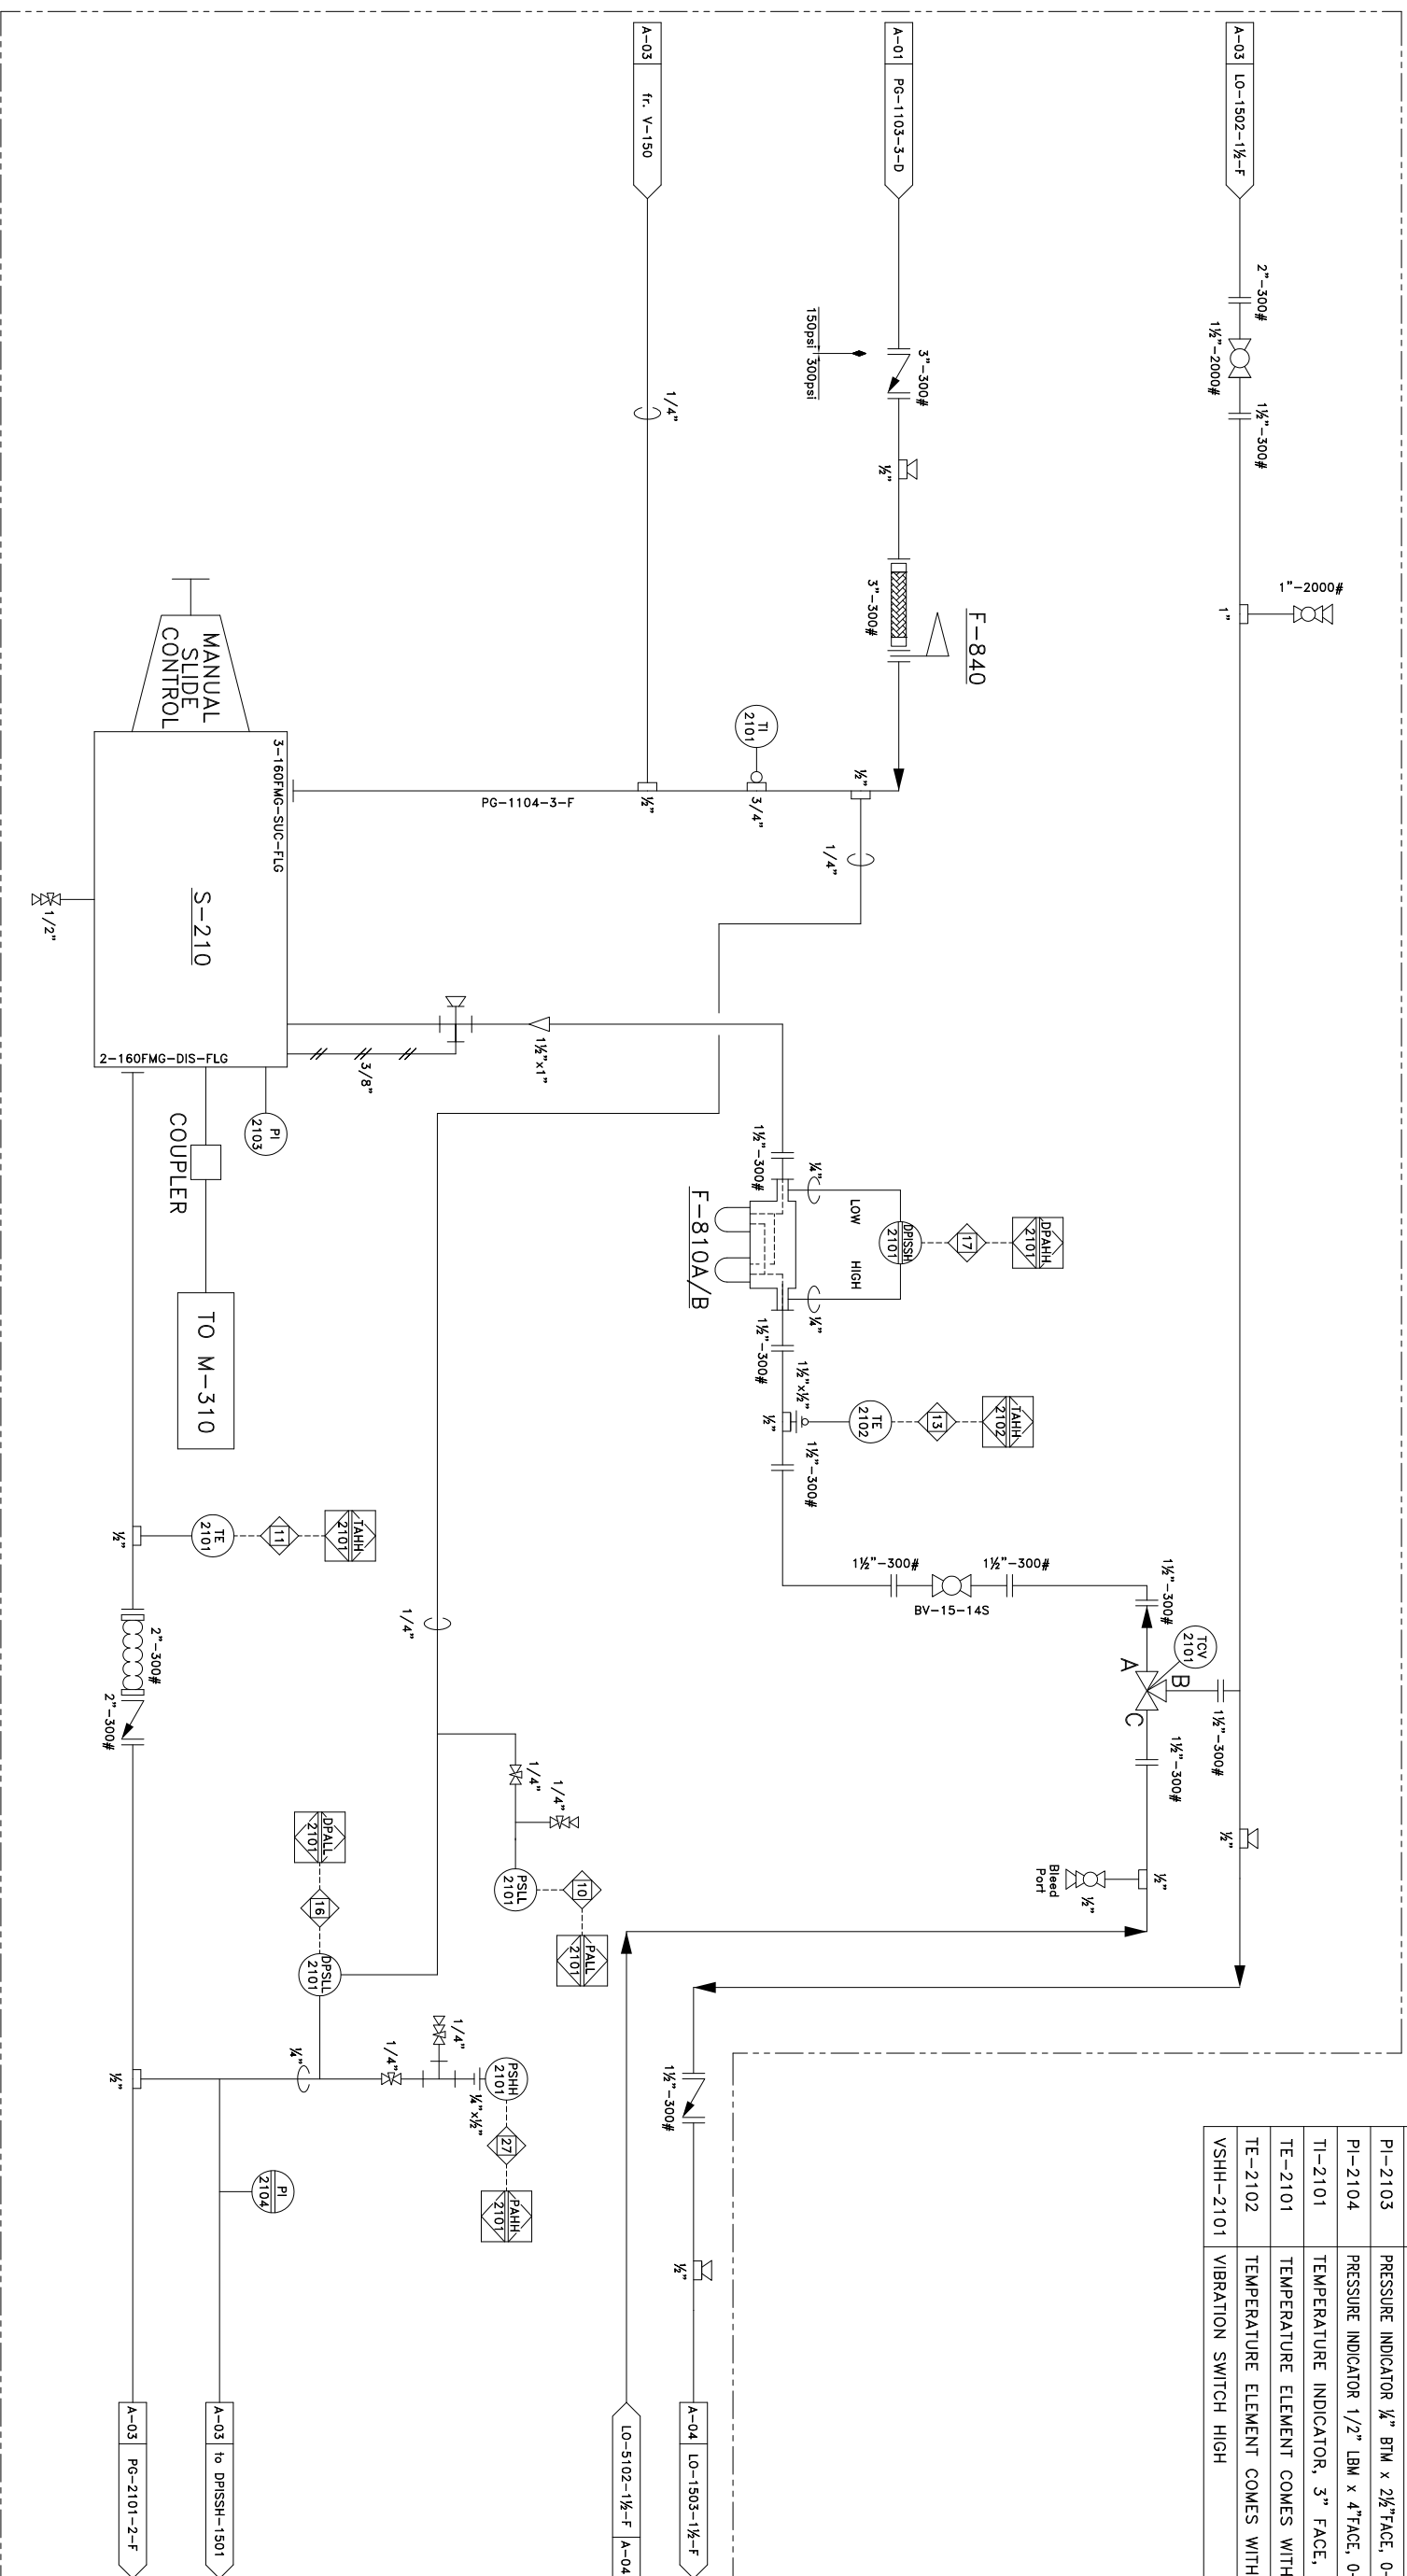

**LINE TYPE LEGEND**

	PROCESS TUBING/ INSTRUMENT SUPPLY
	MAIN PROCESS GAS
	SECONDARY PROCESS
	UTILITY PROCESS
	PNEUMATIC SIGNAL
	HYDRAULIC SIGNAL
	ELECTRIC SIGNAL

REV.	DESCRIPTION	DATE	BY	CHKD	APPD
1	AS BUILT	05-01-18	CAJ	ENG	
0	ISSUED FOR CONSTRUCTION	04-12-02	WST	IR	

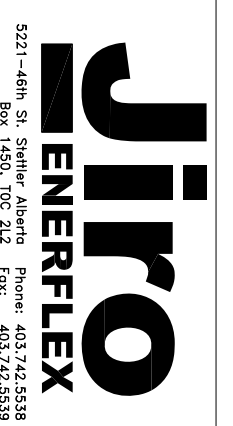

**S3500 SERIES COMPRESSOR**  
FMG 160-L SCREW w/ 3304 NA ENGINE  
TRAILER MOUNTED, SOUR SERVICE

COMPANY: BURLINGTON JOB NO.: 35345  
Drawn by: SLS Checked by: DATE: 04-12-02 SCALE: DRAWING NO.: CDL-55345-A-02 REV.: 1

5221-46th St. Stettler, Alberta Phone: 403.742.5538  
Box 1450, T0C 2L2 Fax: 403.742.5539