


V-110
SUCTION SCRUBBER
Manufacturer: PENFABCO
Size: 24" x 72" S/S
Rated: 285psi @ 100°F
1/8" CA

V-140
INLET GAS FILTER
Manufacturer: PLASMATECH
Model: 3DOLL-ASS
Size: 8" x 27.75" S/S
Type: PARTICULATE
Rated: 180psi @ 450°F

H-410
NATURAL GAS HEATER
Manufacturer: CIS-CAN
Size: 24" x 24"
16,000 btu/hr
12 Volt Start
Protection Grill

H-420
NATURAL GAS HEATER
Manufacturer: CIS-CAN
Size: 12" x 24"
8,000 btu/hr
12 Volt Start
Protection Grill

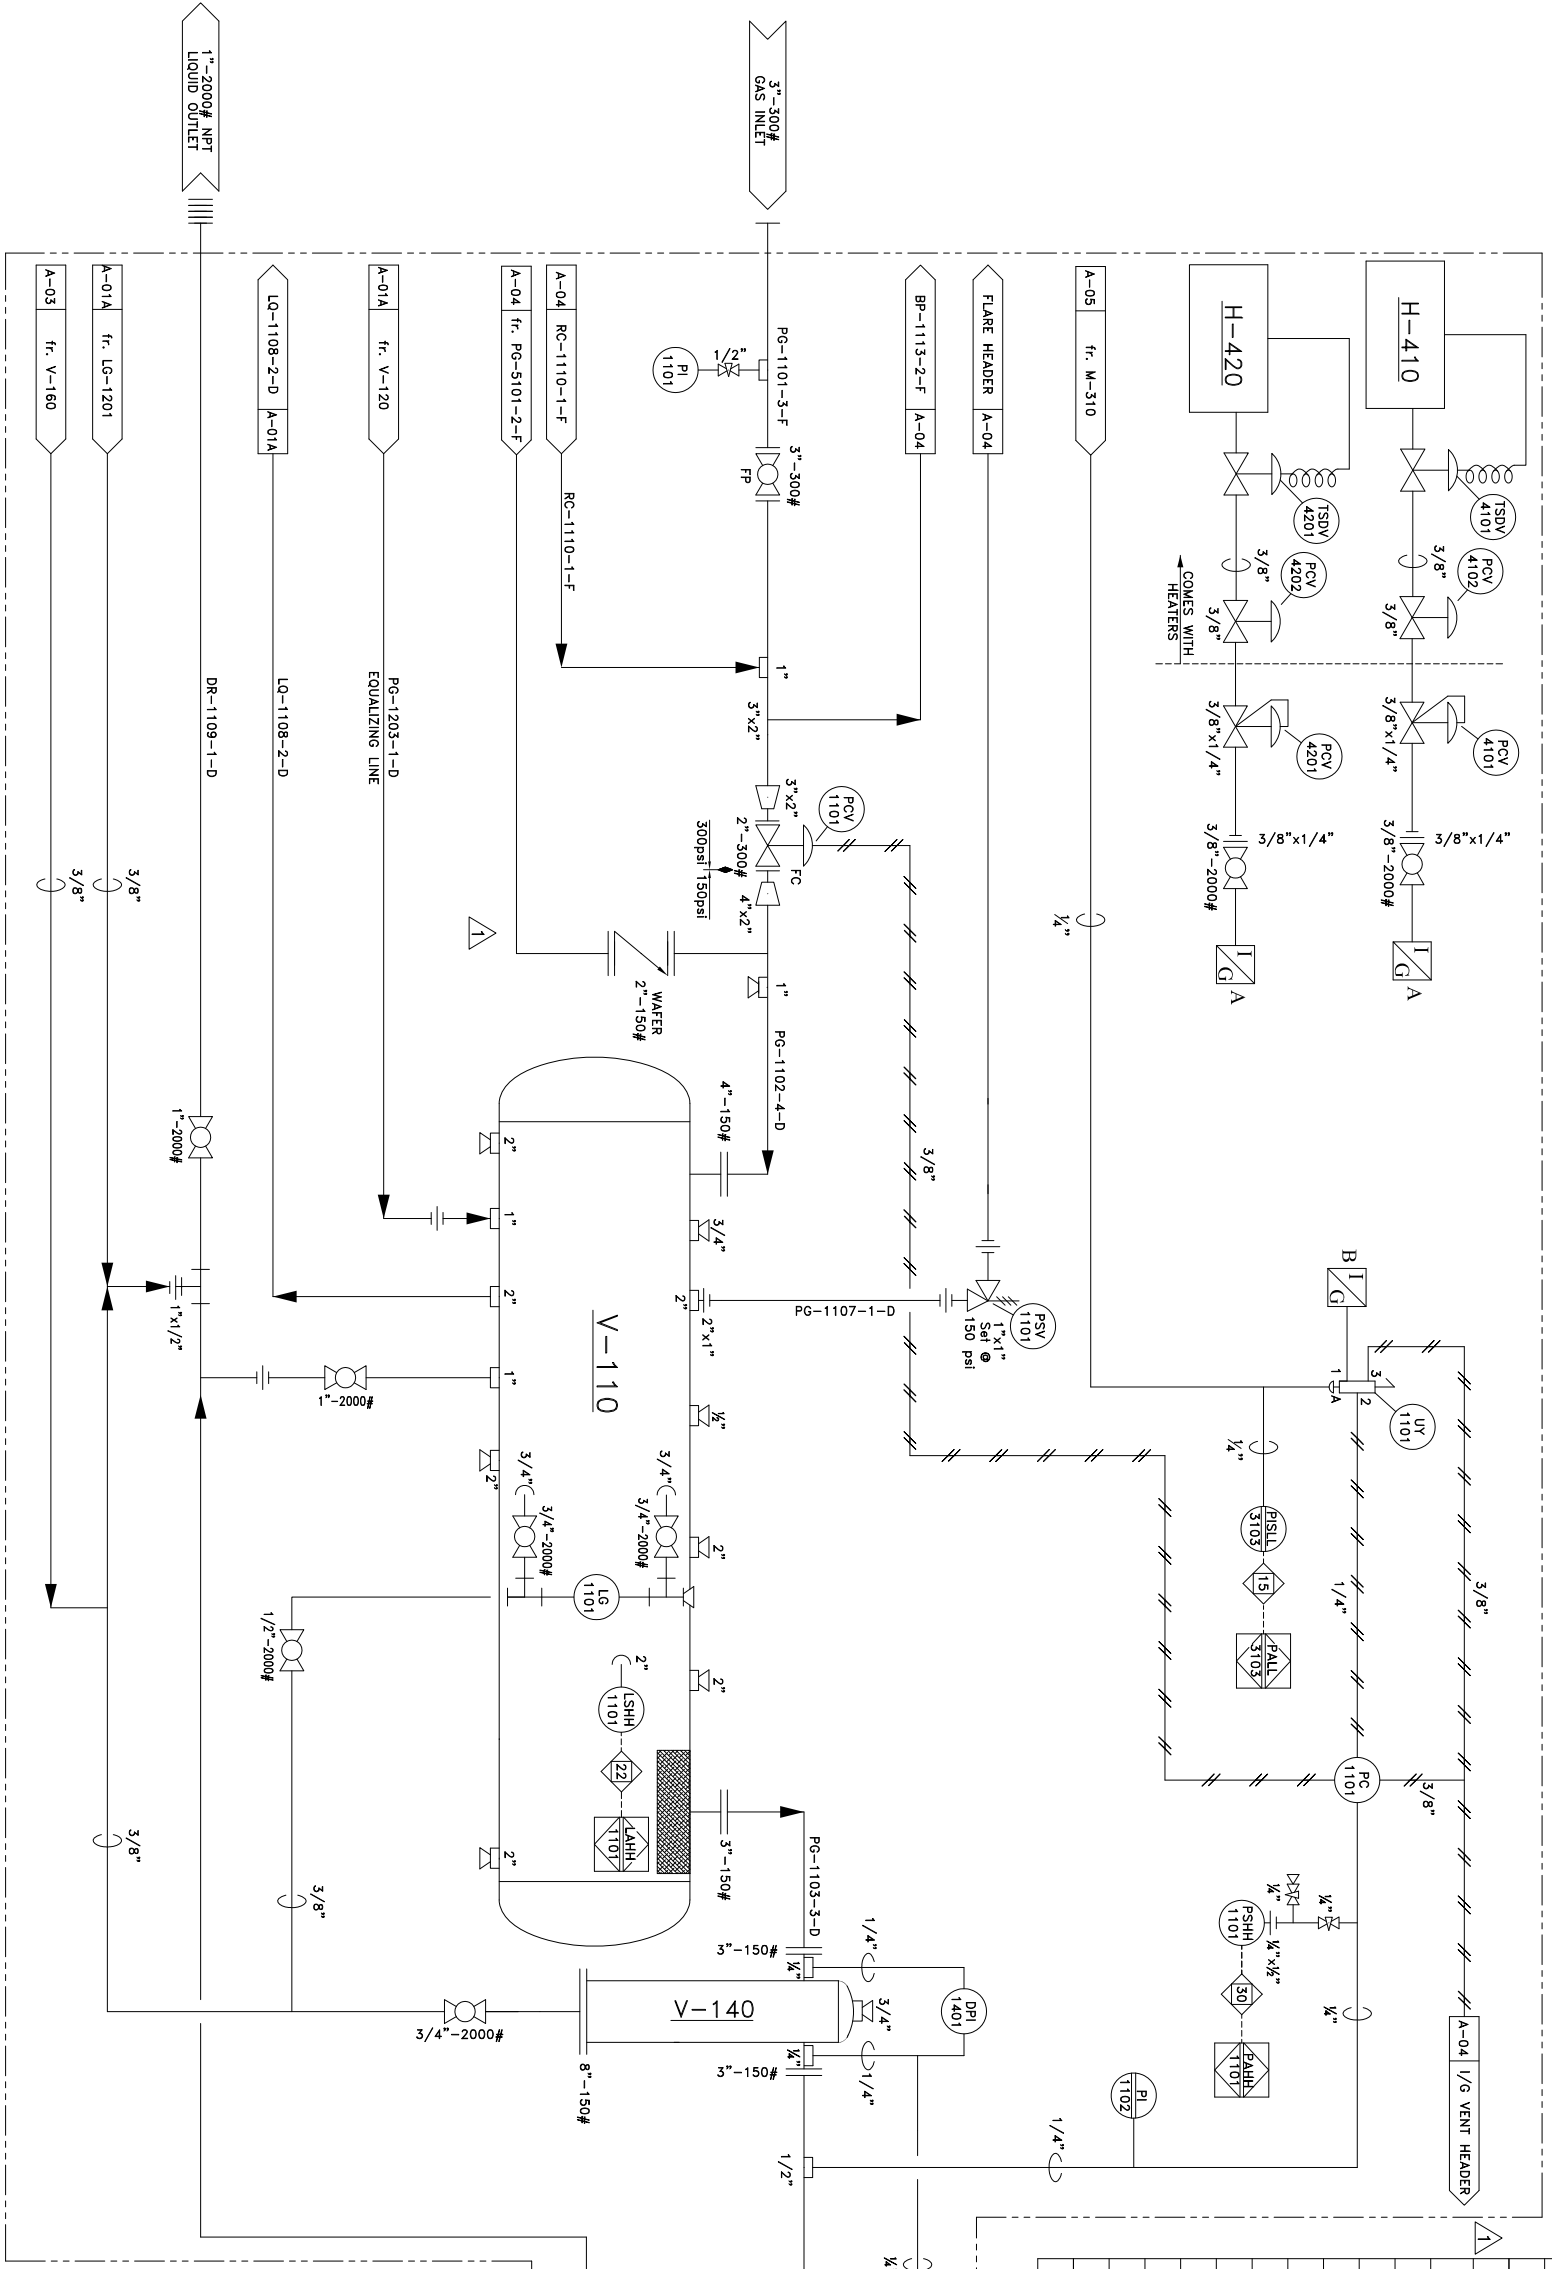

LINE SPEC.

A	=	20psi
B	=	30psi
C	=	100psi
D	=	150psi
E	=	250psi
F	=	300psi

MATERIAL LIST

ITEM	DESCRIPTION	MAKE	MODEL
PSV-1101	PRESSURE SAFETY VALVE, 1"x1" NPT, SET @150 psig	MERCER	E ORIFICE
HS-1101	EMERGENCY SHUTDOWN HAND SWITCH	TELEMECANIQUE	#MIL B174R29H7
LSHH-1101	LEVEL SHUTDOWN HIGH	MURPHY	L1200
UY-1101	PRESSURE SWITCH	AMOT	4057D025H2
PC-1101	PRESSURE CONTROLLER, SPRING RANGE SET @ 0-100 psig	FISHER	4150K
PCV-1101	PRESSURE CONTROL VALVE - FC, 2" 300# VEE-BALL	FISHER	1052-V200
PCV-1102	PRESSURE CONTROL VALVE	FISHER	99 LD
LG-1101	LEVEL GAUGE, SIGHT GLASS w/ 330J VALVES	PENBERTHY	1RM-7STLINE
PI-1101	PRESSURE INDICATOR 1/2"BM x 4"FACE, 0-400psi/0-2800kPa, SSIF	WIKKA	502SB400
PI-1102	PRESSURE INDICATOR 1/2"BM x 4"FACE, -30"HG/100psi, SSIF	WIKKA	7304367
PISL-3103	PRESSURE INDICATING SWITCH/GAGE, 2 1/2"FACE, 0-100psi/0-700kPa	MURPHY	A25FEF-100
DPI-1401	DIFFERENTIAL PRESSURE INDICATOR, 0-50in W.C.	MID-WEST	141AA-00-00
PCV-4101	PRESSURE CONTROL VALVE, SET @ 1/2 psi	FISHER	912/115
PCV-4201	PRESSURE CONTROL VALVE, SET @ 1/2 psi	FISHER	912/115
PCV-4102	PRESSURE CONTROL VALVE, c/w HEATER	MAXITROL	ES404
PCV-4202	PRESSURE CONTROL VALVE, c/w HEATER	MAXITROL	ES404
TSDV-4101	TEMPERATURE SHUTDOWN VALVE, c/w HEATER	BASO	H17GB-5
TSDV-4201	TEMPERATURE SHUTDOWN VALVE, c/w HEATER	BASO	H17GB-5
PSHH-1101	PRESSURE SWITCH HIGH, SET @ 80psi Inc.	CCS	6900GZET18

LINE TYPE LEGEND

	PROCESS TUBING/ INSTRUMENT SUPPLY
	MAIN PROCESS GAS
	SECONDARY PROCESS
	UTILITY PROCESS
	PNEUMATIC SIGNAL
	HYDRAULIC SIGNAL
	ELECTRIC SIGNAL

REV.	DESCRIPTION	DATE	CHKD	APPD
2	AS BUILT	05-01-18	CAD	ENG
1	REVISED FOR SC-1353-C1	05-01-12	WST	IR
0	ISSUED FOR CONSTRUCTION	04-12-02	CAD	ENG

ENERFLEX

5221-46th St. Stettler, Alberta Phone: 403.742.5538
Box 1450, T0C 2L2 Fax: 403.742.5539

T3500 SERIES COMPRESSOR
FMG 160-L SCREW w/ 3304 NA ENGINE
TRAILER MOUNTED, SOUR SERVICE

COMPANY: BURLINGTON JOB NO.: 35345
Drawn by: WST Checked by: Approved by: DATE: 04-03-29 SCALE: DRAWING NO.: CDL-35345-A-01 REV.: 2