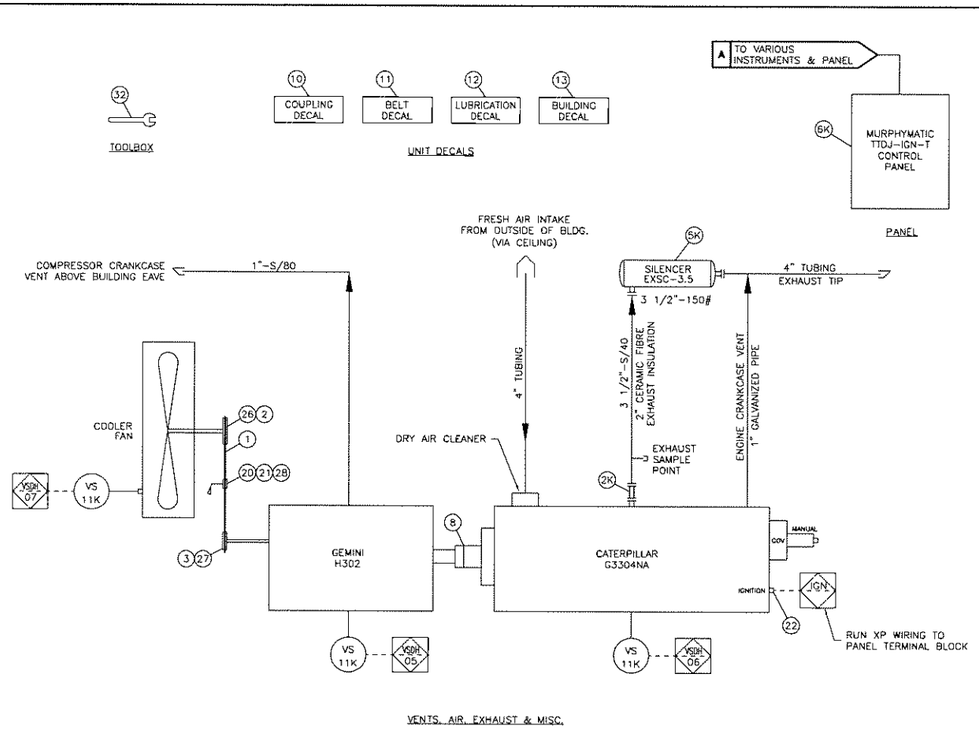

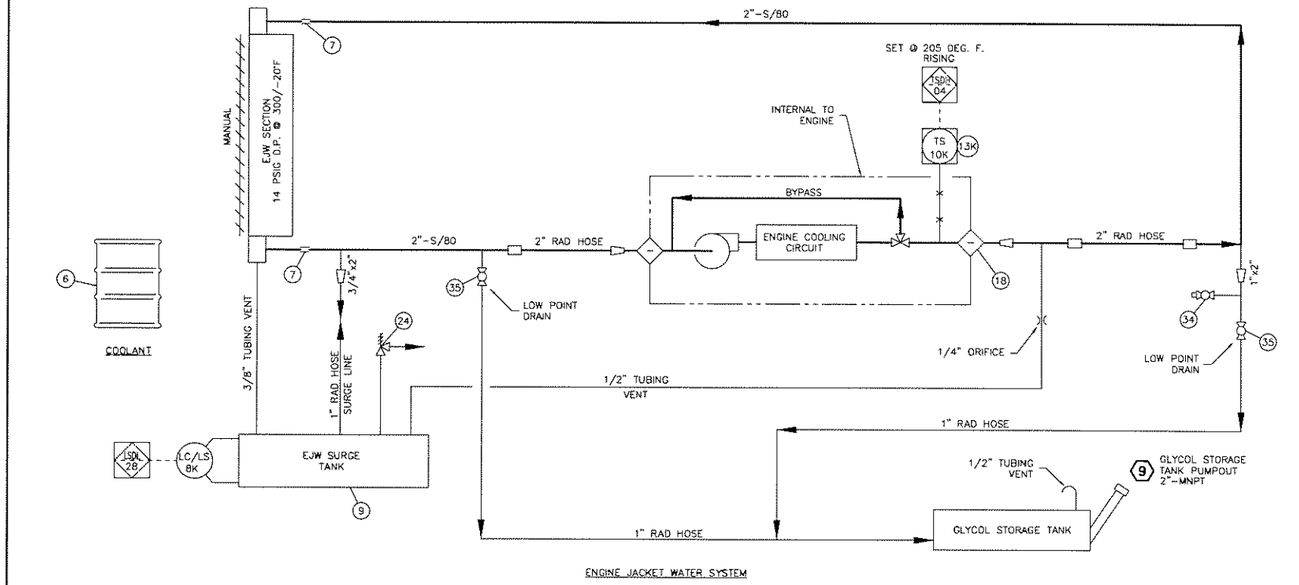

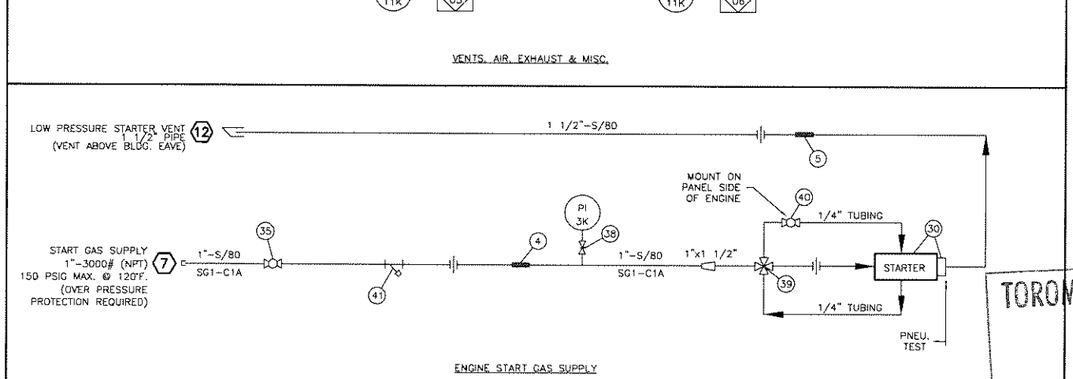

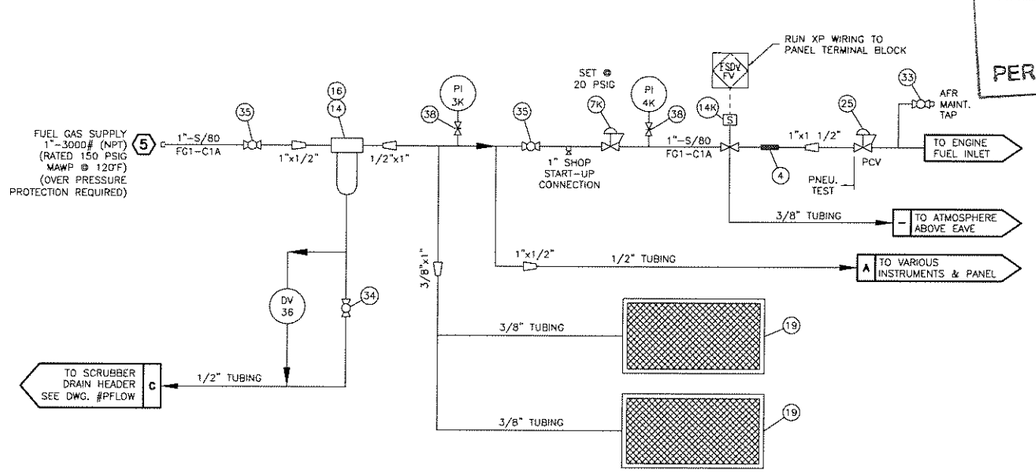

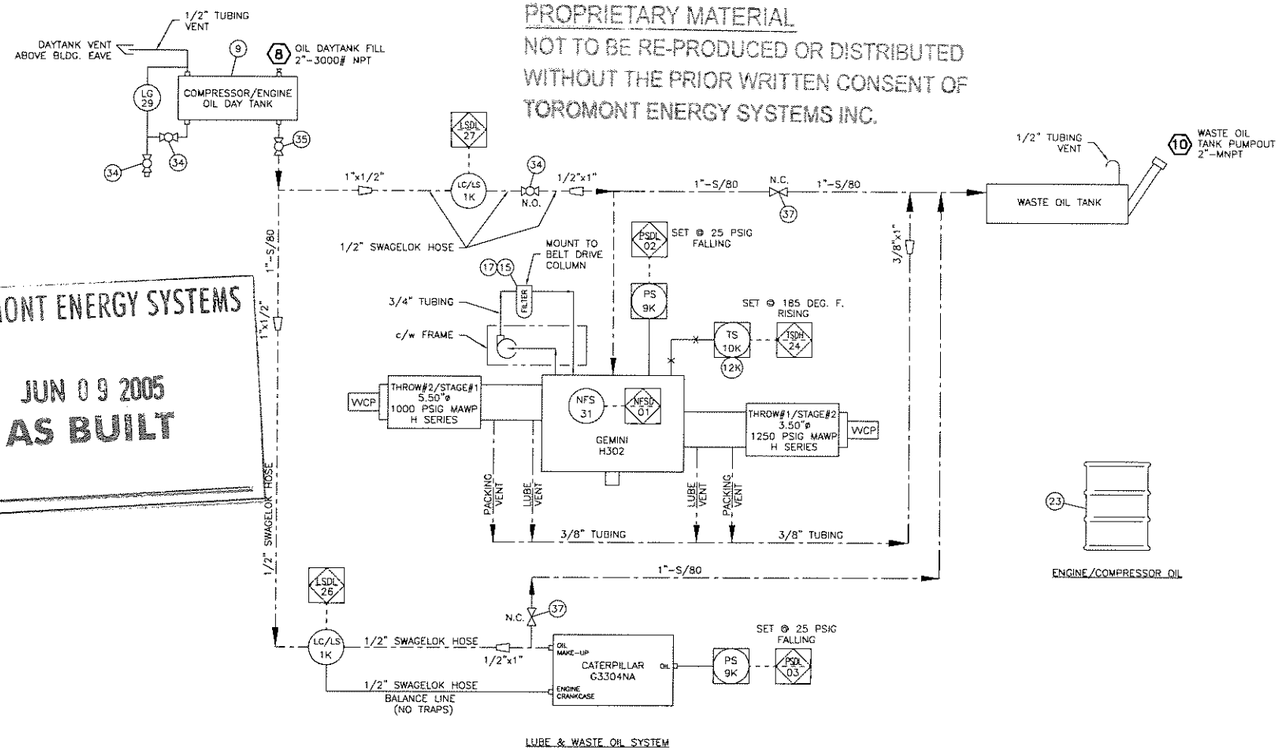

PROPRIETARY MATERIAL
NOT TO BE RE-PRODUCED OR DISTRIBUTED
WITHOUT THE PRIOR WRITTEN CONSENT OF
TOROMONT ENERGY SYSTEMS INC.

TOROMONT ENERGY SYSTEMS
JUN 09 2005
AS BUILT
PER

NOTES

1. START & FUEL VALVES SHOULD BE EASILY ACCESSIBLE.
2. FOR ALL OTHER NOTES AND GENERAL INFORMATION, SEE DWG. #PFLOW.

No.	REVISION	DATE	BY
-	-	06/07/05	GG
1	AS BUILT, RENTED TO TRIFECTA	01/10/05	JN
0	ISSUED FOR CONSTRUCTION	10/29/04	GP

TOROMONT ENERGY SYSTEMS — 10121 - BARLOW TRAIL N.E. CALGARY ALBERTA CANADA

TITLE: UTILITY FLOW DIAGRAM CATERPILLAR G3304NA / GEMINI H302-2 AIR-X-CHANGERS 42EH

CUSTOMER: TRIFECTA RESOURCES CORP. MIKWAN GAS COMPRESSOR LSD: 08-28-38-23 W4M

SCALE: NONE | DATE: 10/29/04 | BY: GP | DATE RELEASED: 06/07/05 | RELEASED BY: DV

STEP # 510 | UNIT # 11558 | DRAWING NO.: 11558-UFLOW | REV. 1